


PLEASE READ THESE NOTES CAREFULLY
 THIS DRAWING IS THE PROPERTY OF ABACUS CONSULTANTS LTD. IT IS TO BE USED ONLY FOR THE PROJECT AND SITE SPECIFICALLY IDENTIFIED HEREON. IT IS NOT TO BE REPRODUCED, COPIED, EITHER WHOLLY OR IN PART, NOR IS IT TO BE LENT, RENTED, HIRED, OR IN ANY MANNER COMMUNICATED TO ANY OTHER PERSON WITHOUT THE WRITTEN PERMISSION OF ABACUS CONSULTANTS LTD.

IMPORTANT
 THE CONTRACTOR TO BE EMPLOYED SHALL BE RESPONSIBLE FOR THE PROTECTION OF THE DRAWING'S CONTENTS. THE CONTRACTOR SHALL BE RESPONSIBLE FOR ANY DAMAGE TO THIS DRAWING WHICH RESULTS FROM HIS NEGLIGENCE OR FROM THE NEGLIGENCE OF ANY SUB-CONTRACTOR OR SUPPLIER.

Note:
 Layout subject to survey being carried out and Building Control Approval.

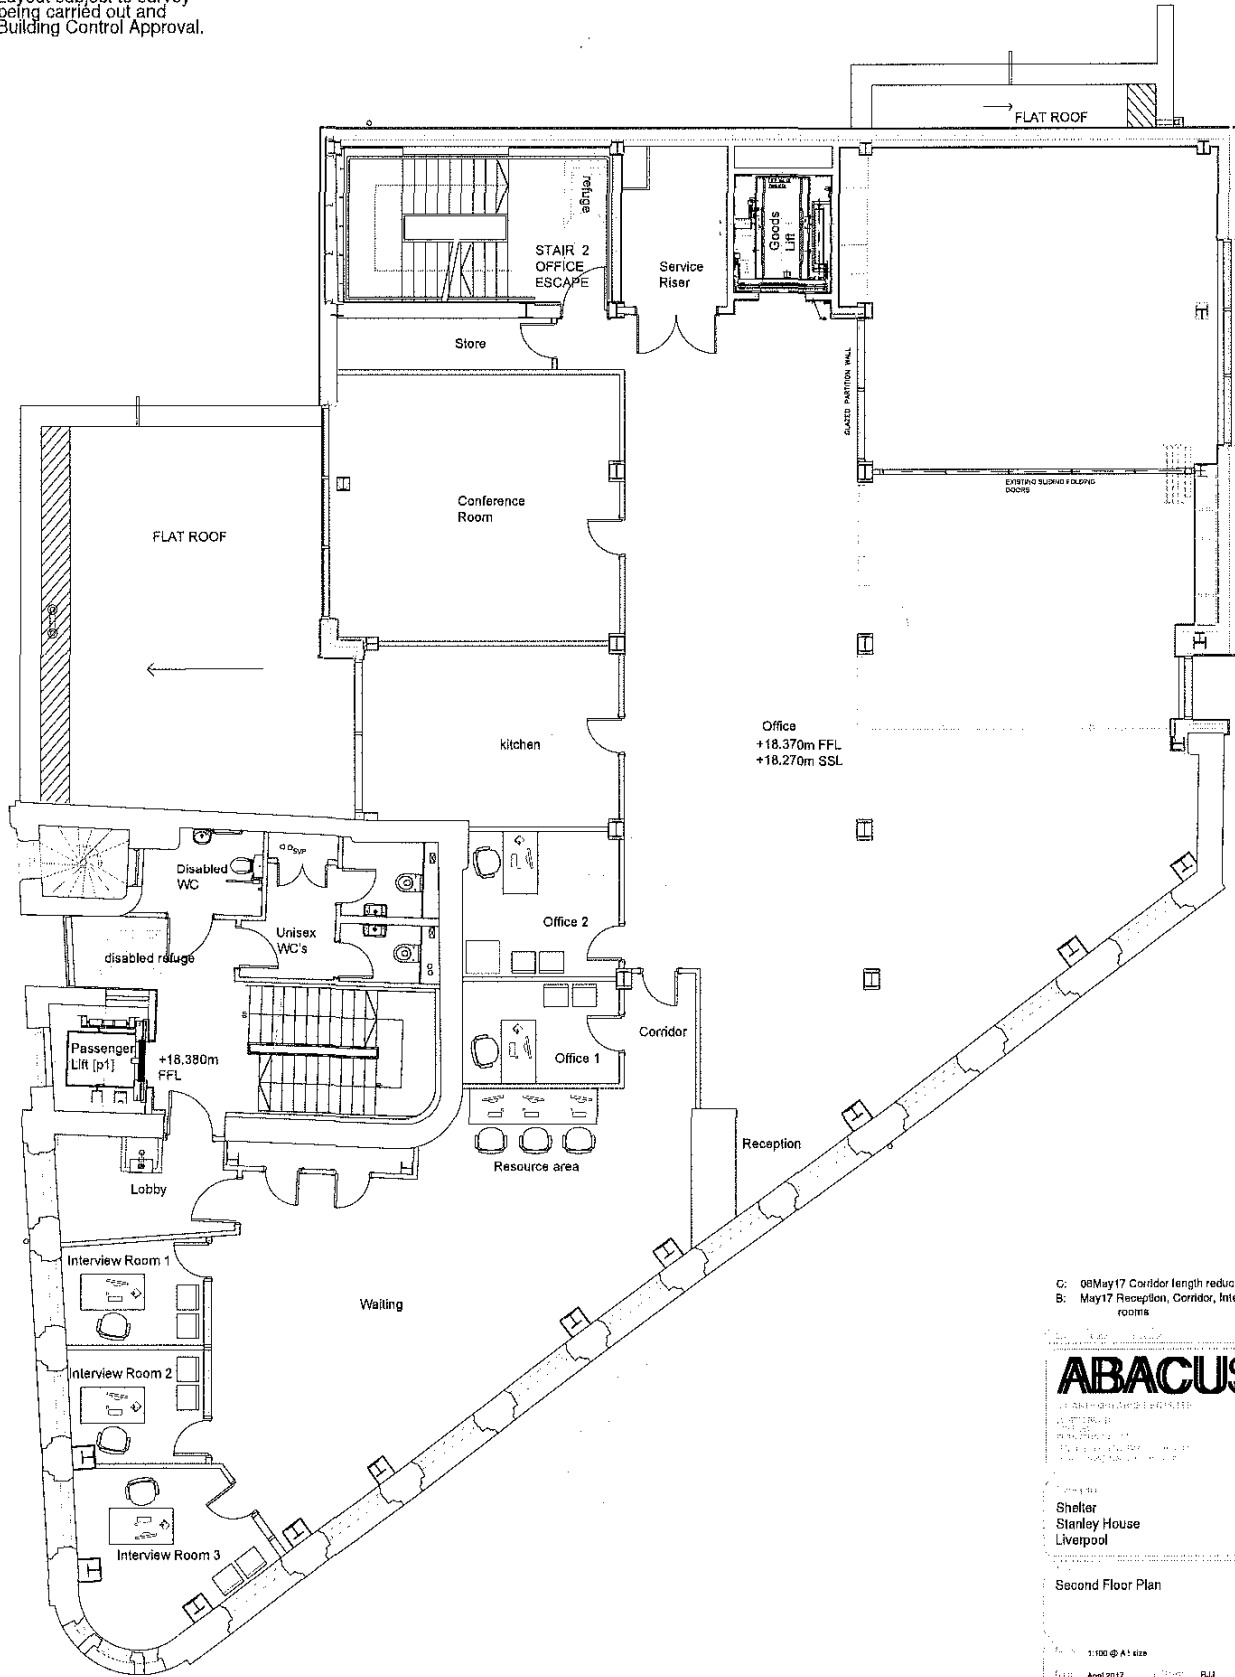

C: 08May17 Corridor length reduced
 B: May17 Reception, Corridor, Interview rooms

ABACUS
 CONSULTANTS LTD
 100-102, The Quadrant, Liverpool, L3 2AB
 Tel: 0151 236 2200
 Fax: 0151 236 2201
 Email: info@abacus-consultants.co.uk

Project:
Shelter Stanley House Liverpool

Second Floor Plan

Scale: 1:100 @ A1 size
 Date: April 2017
 Drawn: RJJ
 No: 1718 SK-100 C