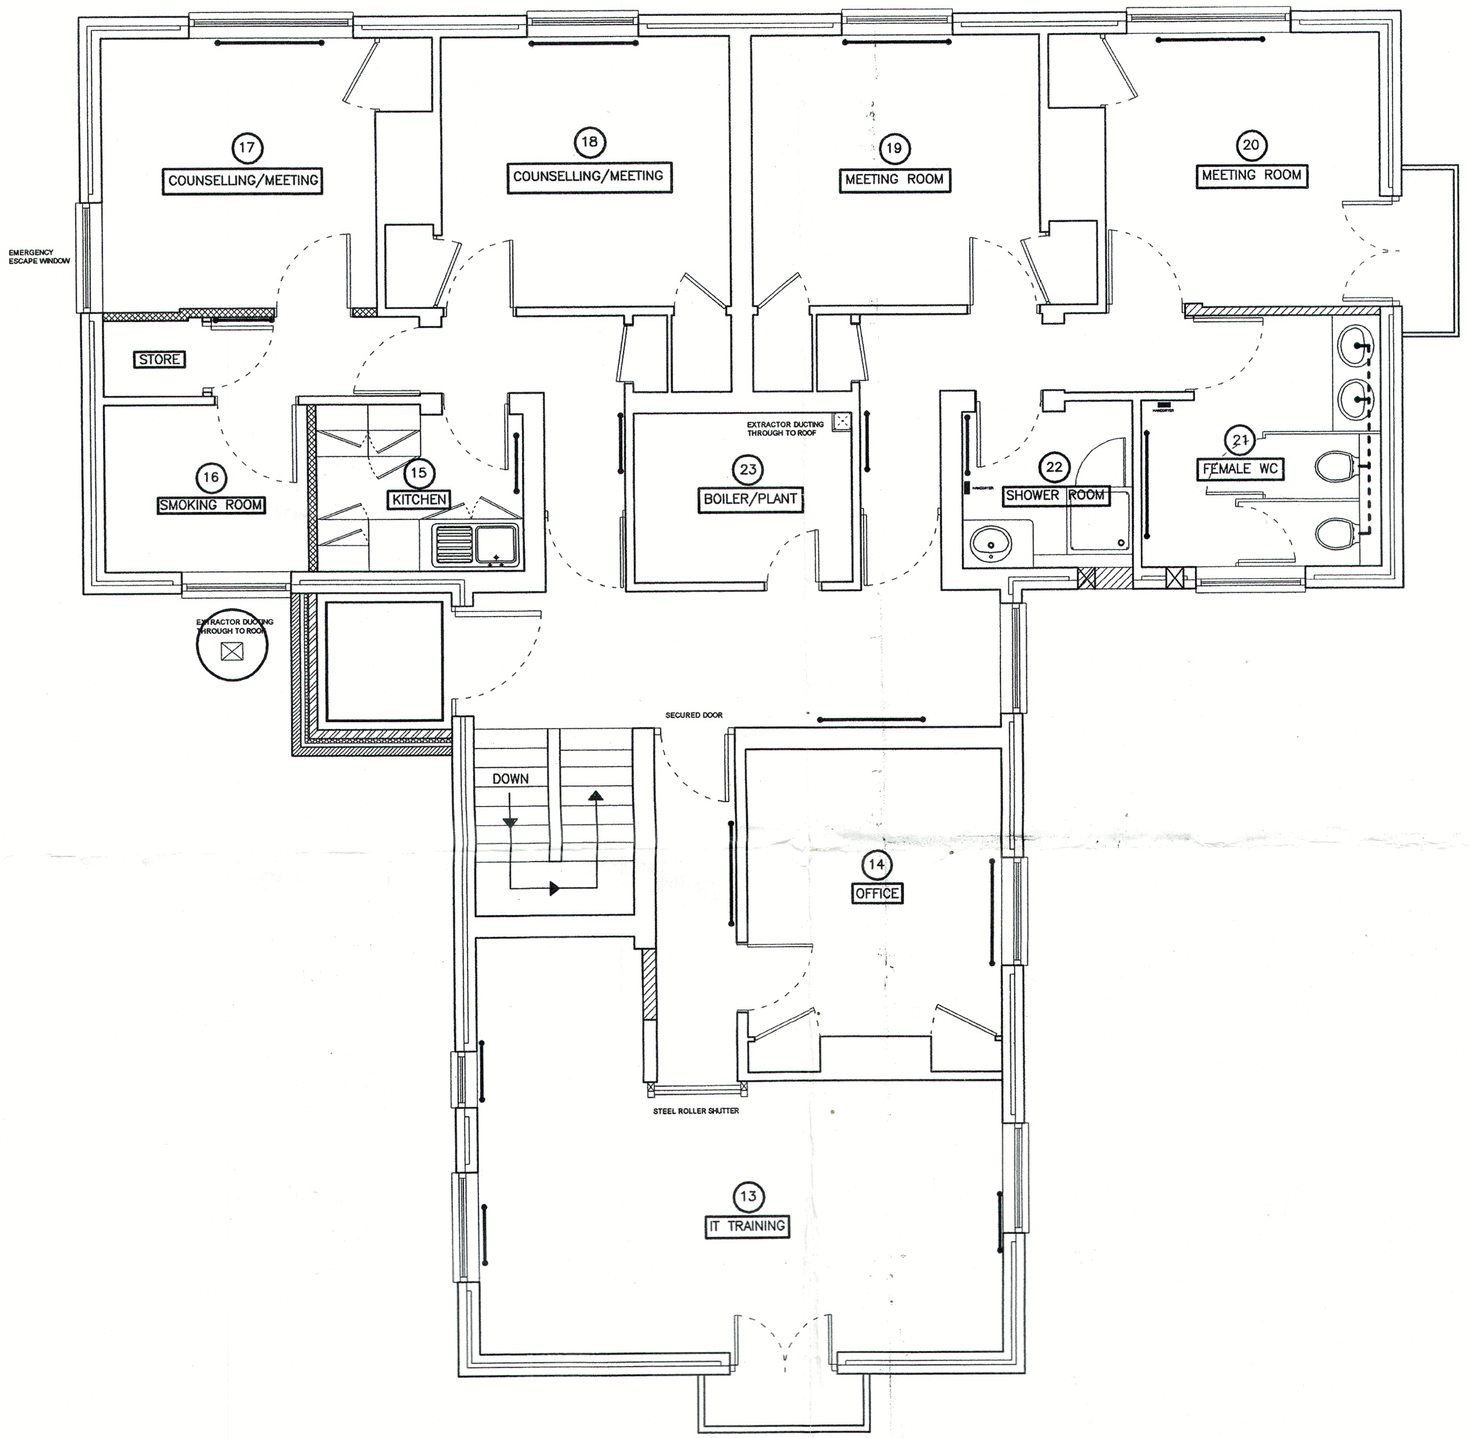

Rev.		Initials	Date	Rev.		Initials	Date

Notes:
1. This drawing is subject to copyright and is not to be reproduced in part or whole without approval.
2. Do not scale this drawing – Check all dimensions on site.

PRELIMINARY ☐
INFORMATION ONLY ☐
FOR CONSTRUCTION ☐
FINAL / AS BUILT ☒

Checked by: .....

Project
101-105A CHERRYFIELD DRIVE

AS BUILT 1st FLOOR LAYOUT

Client YWCA

drawn J.B.
date 10.2005
scale 1:50
drawing number 1st F-01

CASSIDY + ASHTON
Architects Building Surveyors Planners Designers
7 East Cliff, Preston, Lancashire, PR1 3JE. Tel: 01772 258356 Fax: 01772 825000
1 Regency Chambers, Jubilee way, Bury, Greater Manchester, BL9 0JW. Tel: 0161 762 5800 Fax: 0161 762 5801
Cheshire House, Gorsey Lane, Widnes, WA8 0PR. Tel: 0151 4236914 Fax: 0151 4236915
C+A