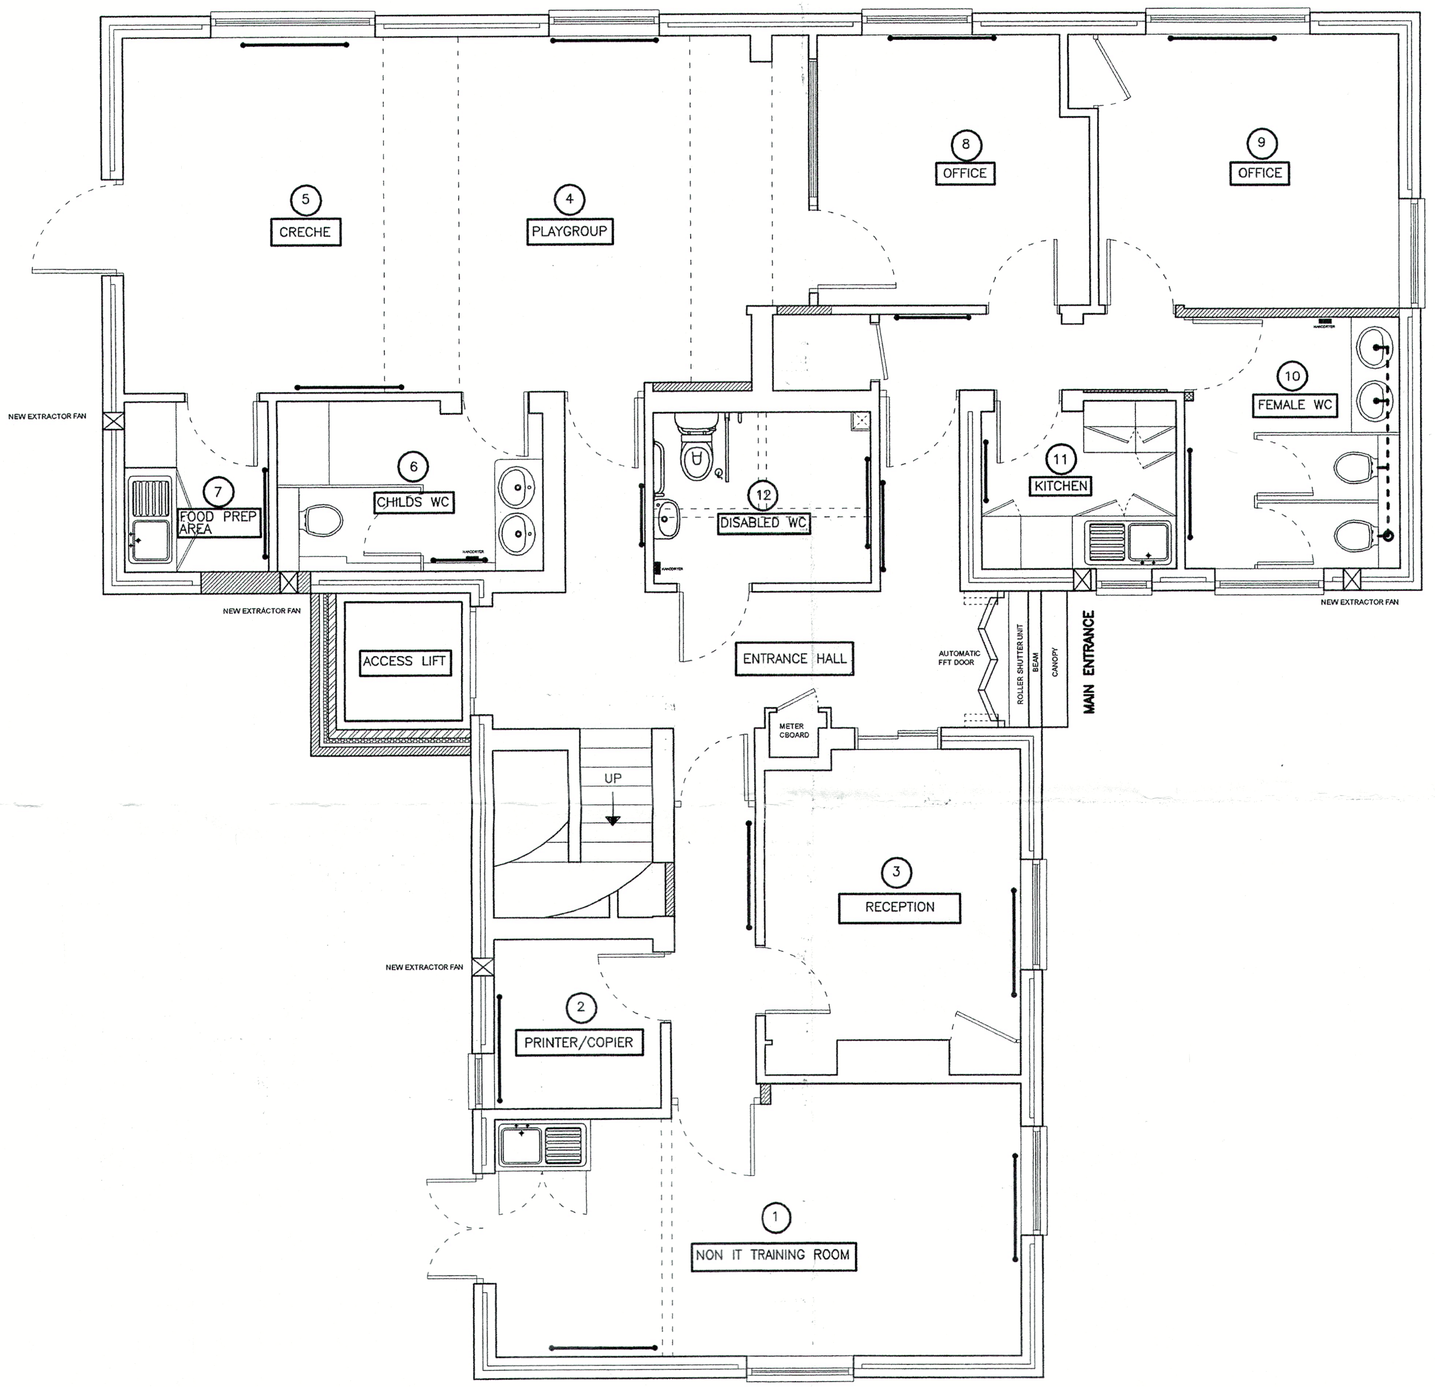

Rev.		Initials	Date	Rev.		Initials	Date

Notes:
1. This drawing is subject to copyright and is not to be reproduced in part or whole without approval.
2. Do not scale this drawing – Check all dimensions on site.

PRELIMINARY ☐
INFORMATION ONLY ☐
FOR CONSTRUCTION ☐
FINAL / AS BUILT ☒

Checked by: .....

Project
101-105A CHERRYFIELD DRIVE
AS BUILT GROUND FLOOR LAYOUT

Client: YWCA

drawn: J.B.
date: 10.2005
scale: 1:50
drawing number: GF -01

CASSIDY + ASHTON
Architects Building Surveyors Planners Designers
7 East Cliff, Preston, Lancashire PR1 3JE. Tel: 01772 258356 Fax: 01772 825000
1 Regency Chambers, Jubilee way Bury, Greater Manchester BL9 0JW. Tel: 0161 762 5800 Fax: 0161 762 5801
Cheshire House, Gursey Lane, Widnes, WA8 0PH. Tel: 0151 4236914 Fax: 0151 4236915
C+A