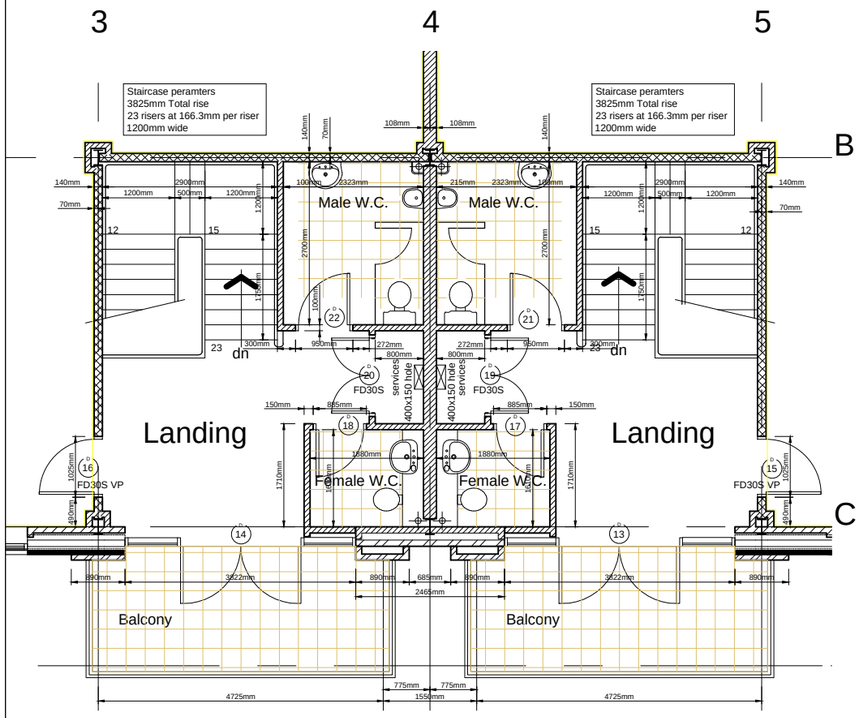

FIRST FLOOR CORE SETTING OUT
SCALE 1:50

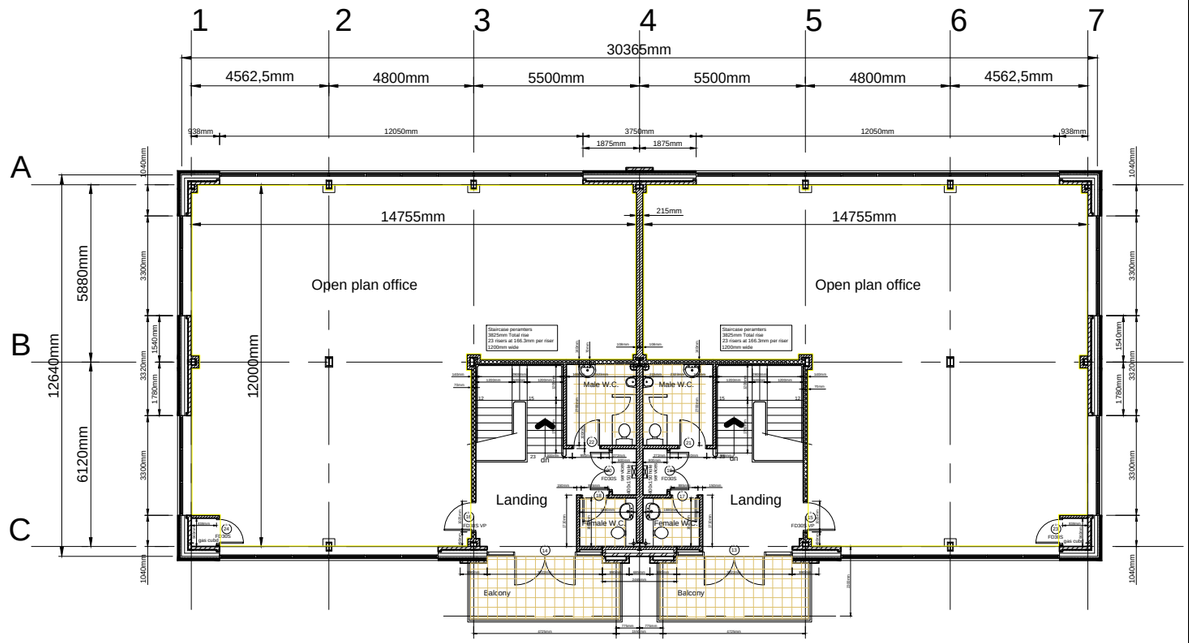

FIRST FLOOR LAYOUT

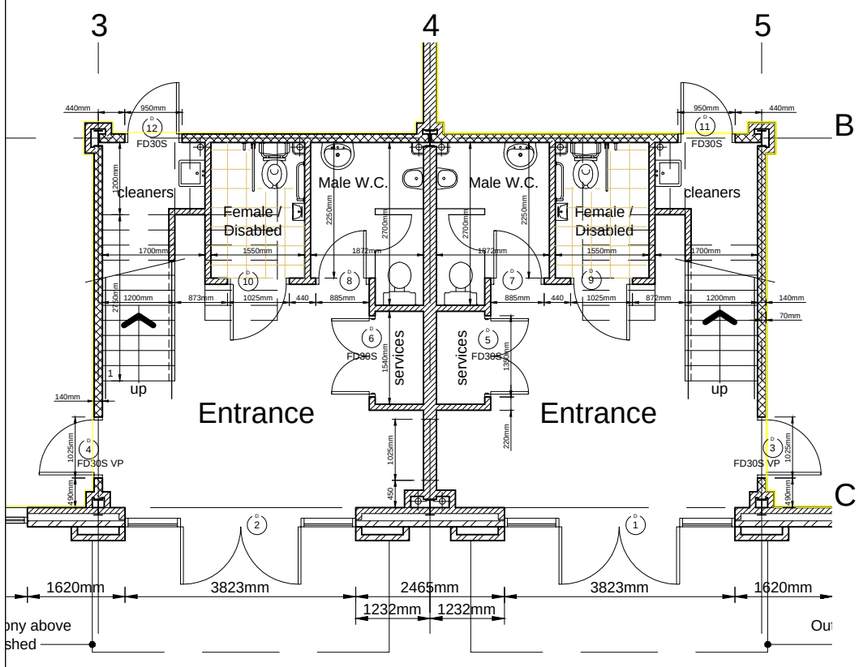

GROUND FLOOR CORE SETTING OUT
SCALE 1:50

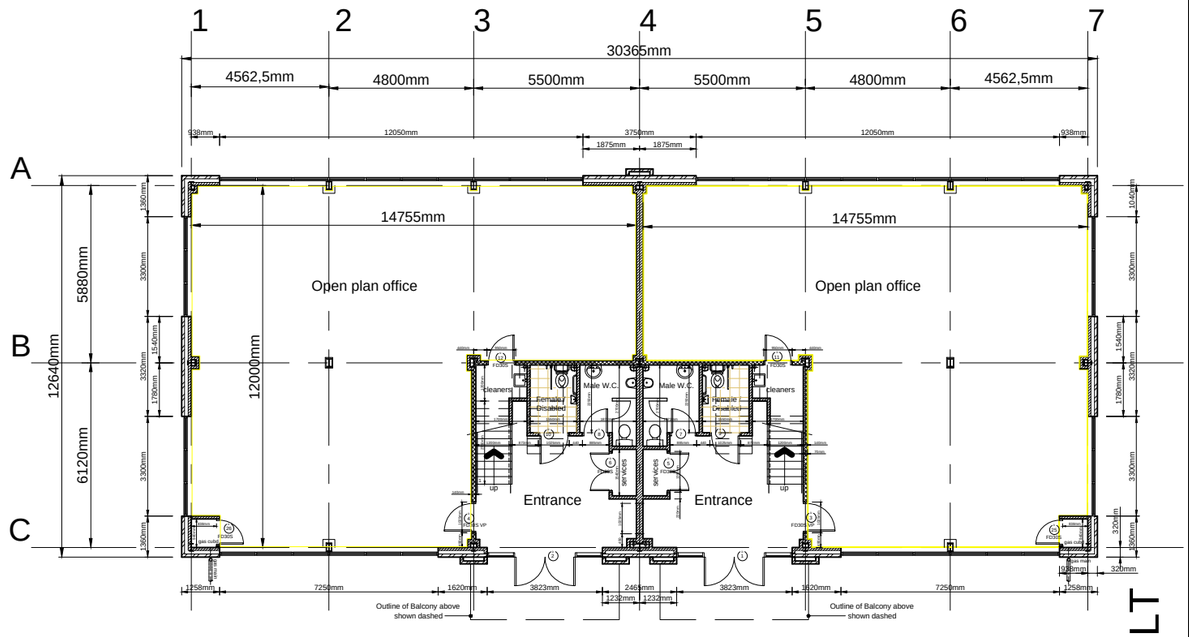

GROUND FLOOR LAYOUT

AS-BUILT

COPYRIGHT RESERVED

Notes

Revisions

Rev	Date	Description
REV.A.	JAN.07	GRID DIM A - B AMENDED
REV.B.	JAN.07	D1,2,13 & 14 WIDTH AMENDED
REV.C.	JAN.07	BOILER ROOMS ADDED
REV.D.	FEB.07	ALL 1010mm WIDE DOOR OPENINGS INCREASED TO 1025mm
REV.E.	MAR.07	GAS CUPBOARD POSITION REVISED
REV.F.	APR.07	BLOCKWORK BELOW STAIRCASE ADDED

BUILDING MANAGEMENT SERVICES LTD

Huddersfield Road
Elland, West Yorkshire
HX5 9BW
TELEPHONE : ELLAND (01422) 371616
FAX No : (01422) 376717
email : mail@bmselland.com

Building Management Services

Client

C.D.P. LIMITED

Project

OFFICE DEVELOPMENT
TIGER COURT
KINGS BUSINESS PARK, KNOWSLEY

Sheet

UNIT 13 FLOOR LAYOUT PLANS

Drawn	Date
N.D. JORDAN	OCT.06
Scale	
1:50 & 1:100	
Status	
Drawing No.	Revision
M2372-13-01	REV.F.